



1 EXSTING FIRST FLOOR PLAN
1/4"=1'-0"

EXISTING
FIRST FLOOR PLAN



DAVIS BUILDING
AS-BUILT
5600 OLD WADSWORTH BOULEVARD
ARVADA, CO 80002

Issue AS-BUILT Date 02/12/10

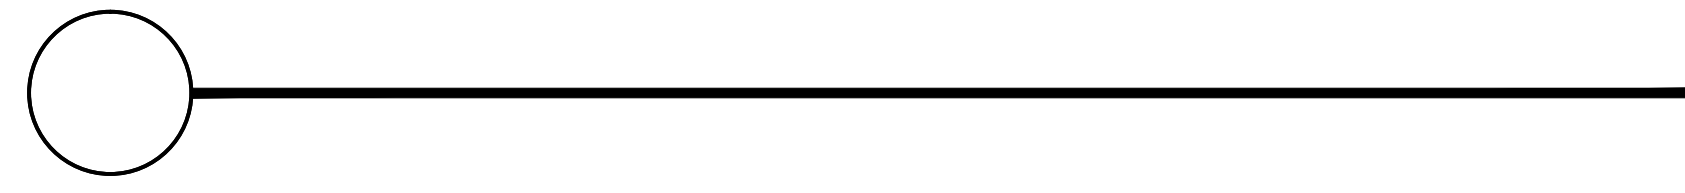

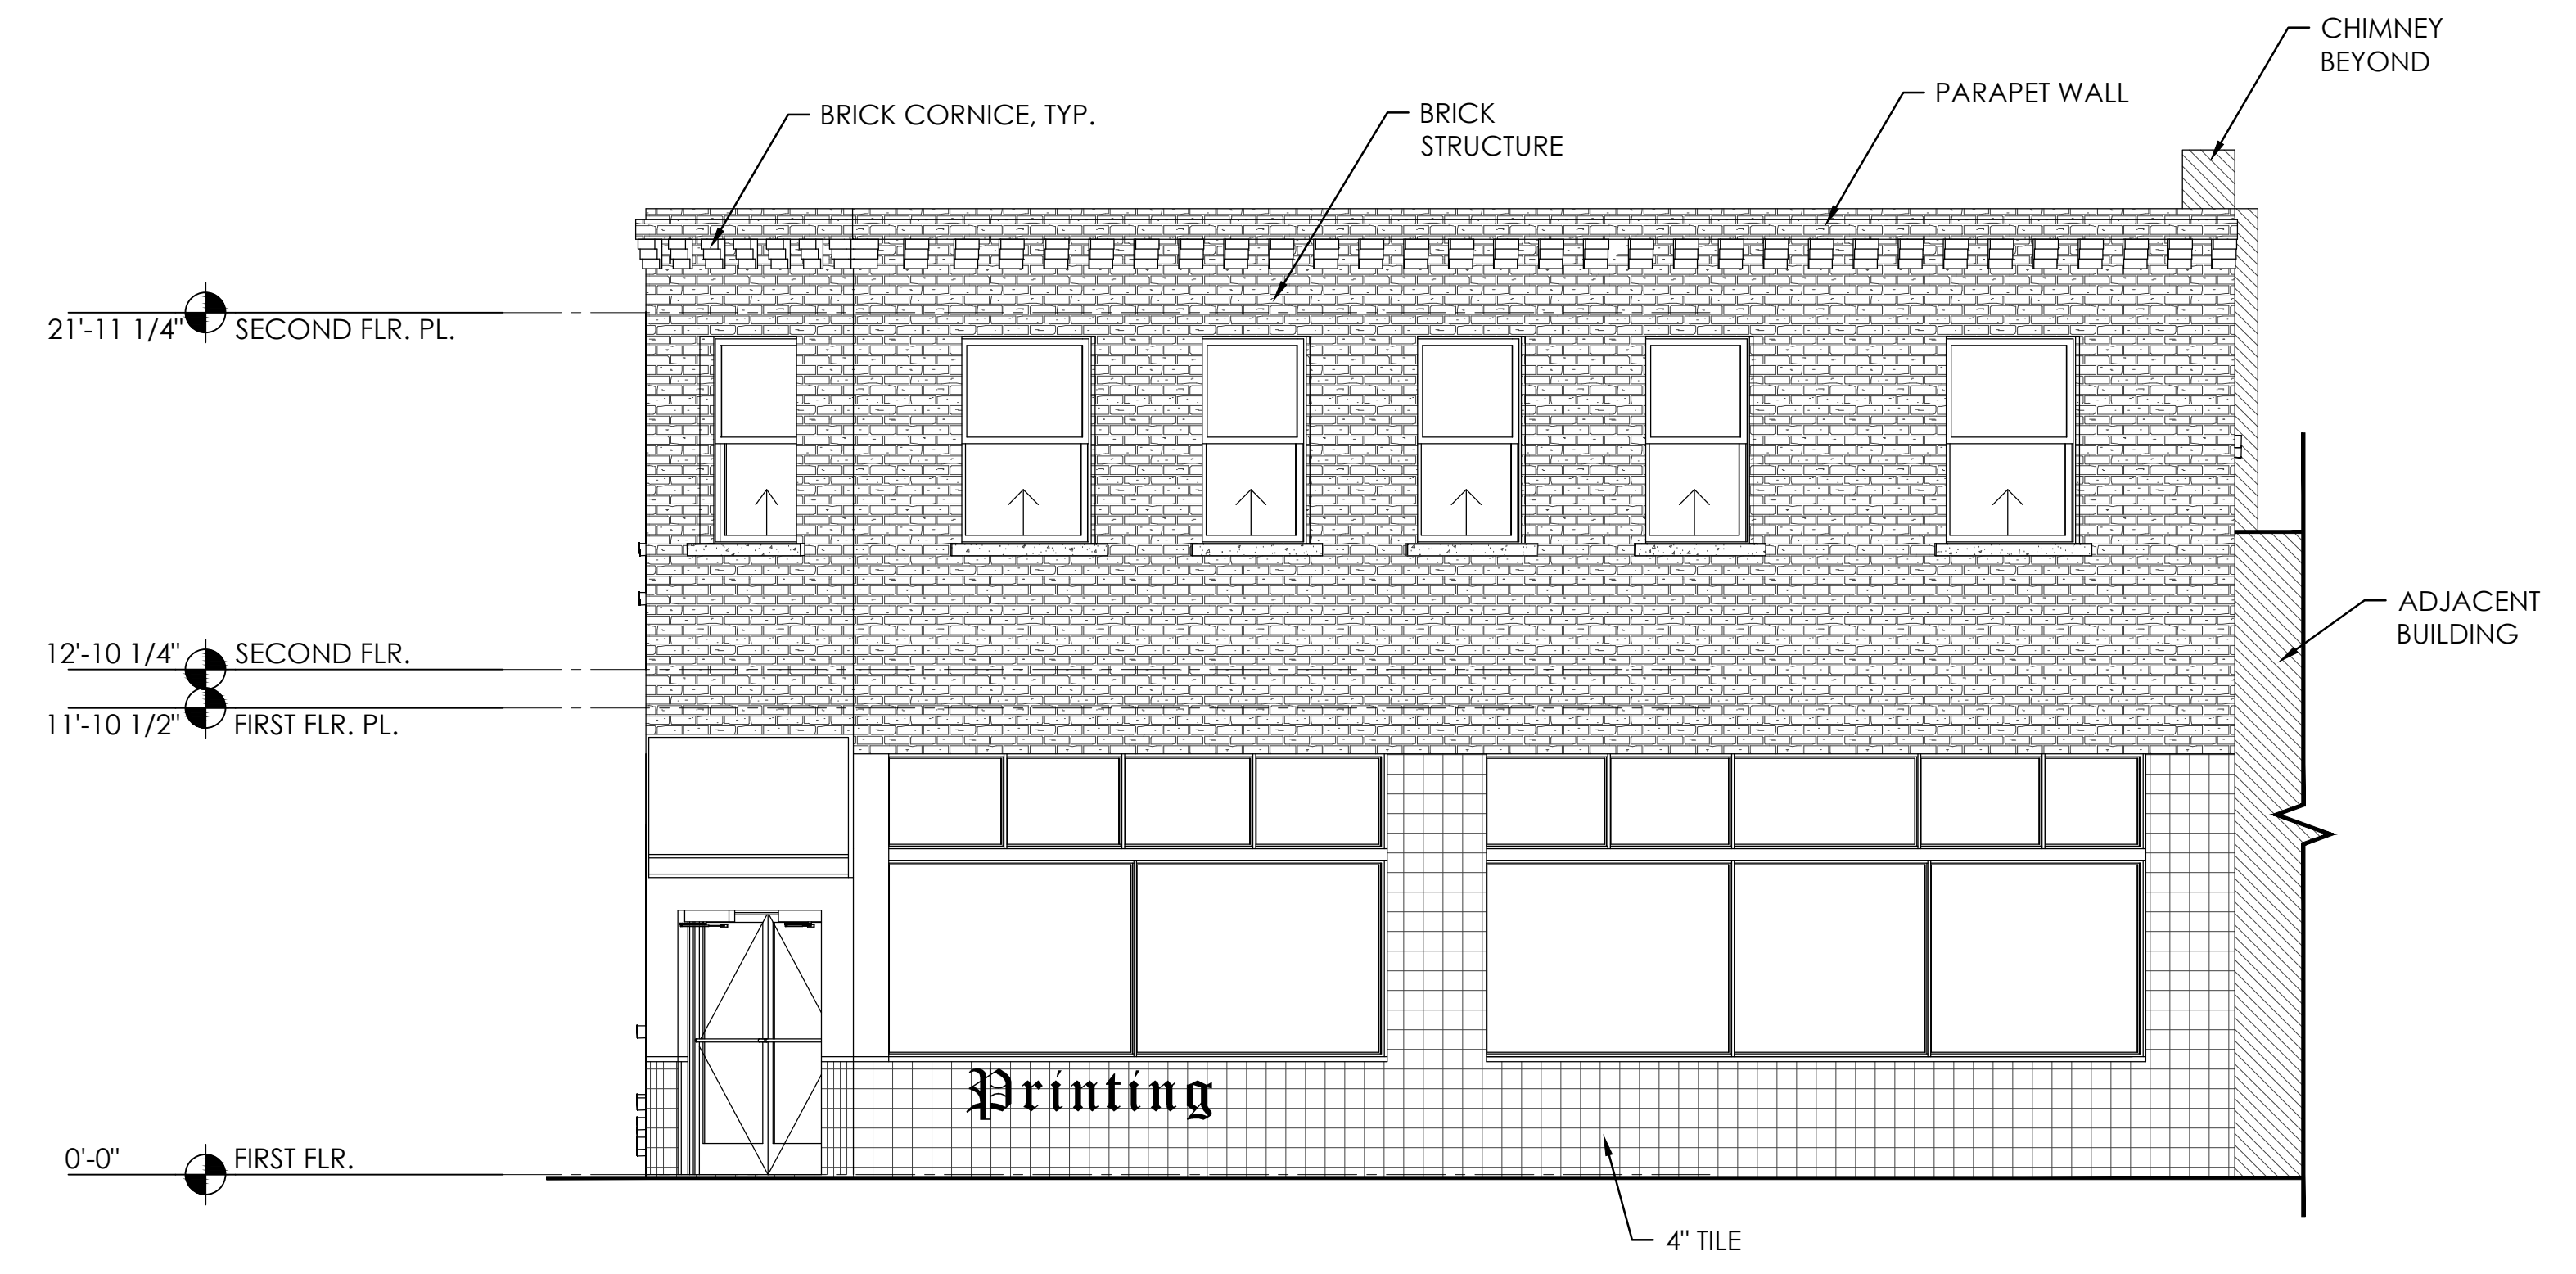

1 EXISTING SOUTH (RIGHT SIDE) ELEVATION
1/4"=1'-0"

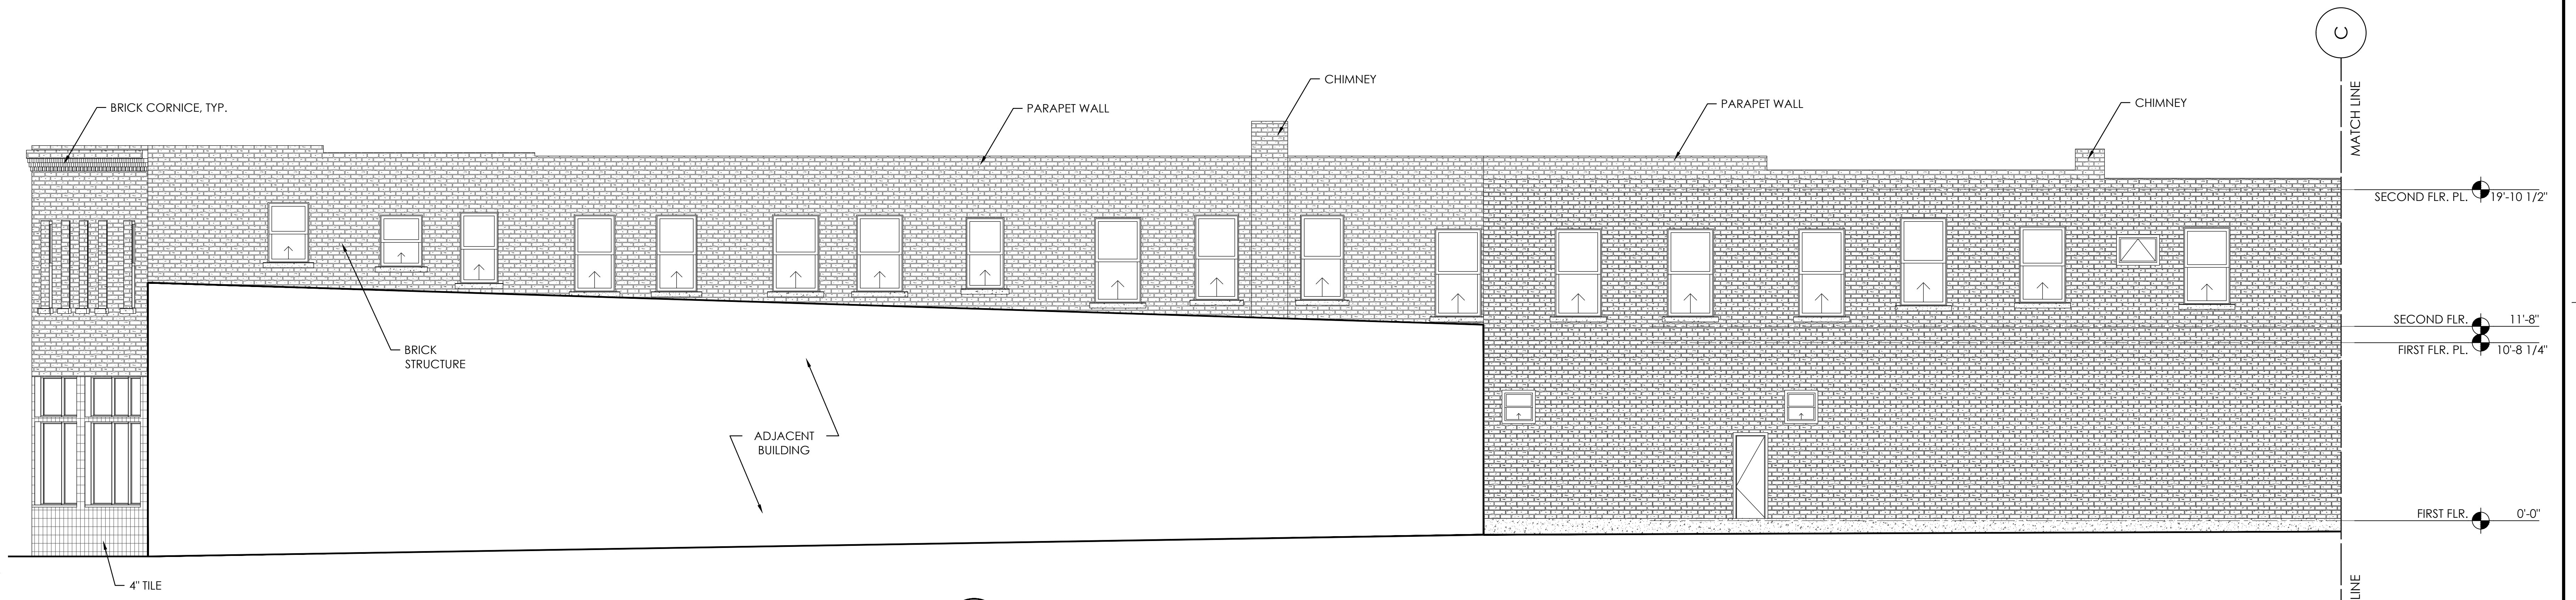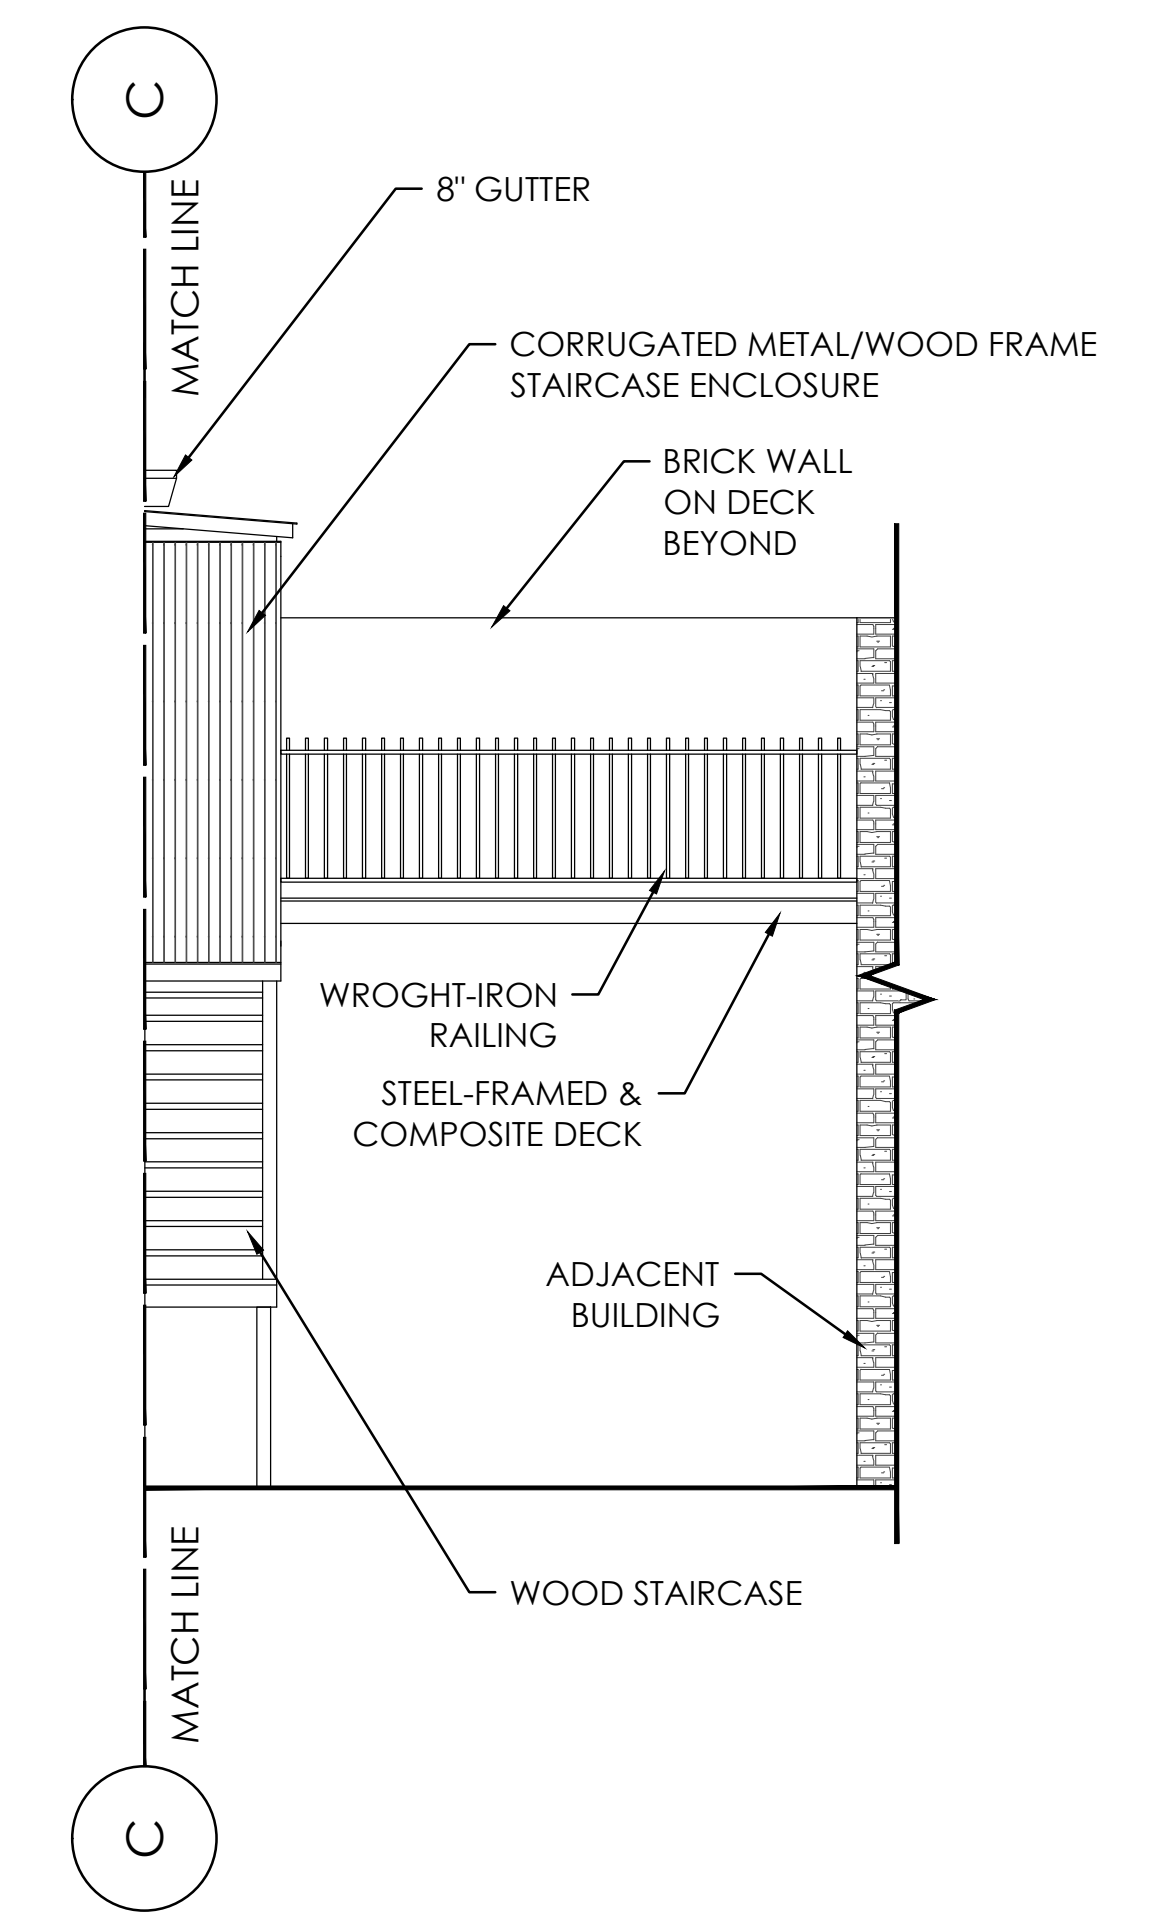

2 EXISTING EAST (REAR) ELEVATION
1/4"=1'-0"

